


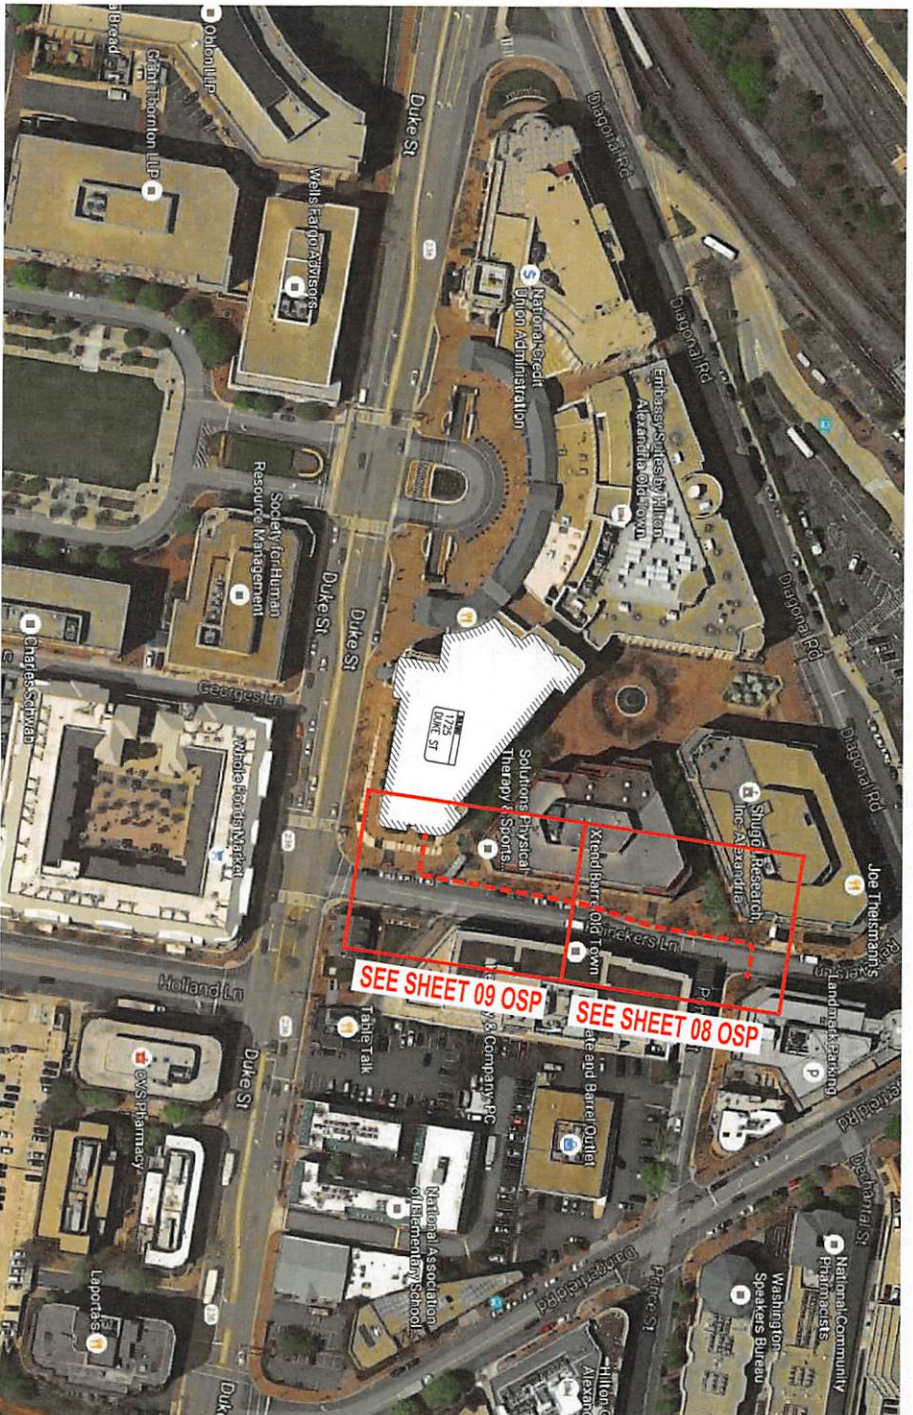

AERIAL IMAGE



Express-tek
11777 Newmarket Parkway, Suite 200, Newmarket, VA 22643

PERMIT
NOT FOR
CONSTRUCTION



3	03/04/17	TS	AA	AS-BUILT
2	03/04/17	TS	TH	REVISION
1	12/20/16	TS	TH	ORIGINAL
NO	DATE	ENG	DESIGN	DRAWING
Level (3)				
LEVEL 3 ENGINEER: CHRISTOPHER BAKER				
ENGINEERING FIRM: EXPRESS TECHNOLOGIES, INC.				
PROJECT NUMBER:				
LOCATION: 1725 DUKE STREET DIAGONAL RD				
DRAWING NAME: (1805) 1725 DUKE ST - Permit Draw 1.dwg				
CONFIDENTIAL / PROPRIETARY				