

ADDRESS OF PROJECT: 219 NORTH ROYALTAX MAP AND PARCEL: 65.03-10-37 ZONING: RM

APPLICATION FOR: (Please check all that apply)

- ☒ CERTIFICATE OF APPROPRIATENESS
- ☒ PERMIT TO MOVE, REMOVE, ENCAPSULATE OR DEMOLISH
(Required if more than 25 square feet of a structure is to be demolished/impacted)
- ☐ WAIVER OF VISION CLEARANCE REQUIREMENT and/or YARD REQUIREMENTS IN A VISION CLEARANCE AREA (Section 7-802, Alexandria 1992 Zoning Ordinance)
- ☐ WAIVER OF ROOFTOP HVAC SCREENING REQUIREMENT
(Section 6-403(B)(3), Alexandria 1992 Zoning Ordinance)

Applicant: ☒ Property Owner ☐ Business (Please provide business name & contact person)Name: DAVID & RIXEY CANFIELDAddress: 219 NORTH ROYAL STCity: ALEXANDRIA State: VA Zip: 22314

Phone: _____ E-mail: _____

Authorized Agent (if applicable): ☐ Attorney ☐ Architect ☒ DESIGNERName: PATRICK CAMUSPhone: 703 626 1984E-mail: studhocamus@comcast.net

Legal Property Owner:

Name: SAME


Address: _____

City: _____ State: _____ Zip: _____

Phone: _____ E-mail: _____

- ☐ Yes ☒ No Is there an historic preservation easement on this property?
- ☐ Yes ☐ No If yes, has the easement holder agreed to the proposed alterations?
- ☐ Yes ☒ No Is there a homeowner's association for this property?
- ☐ Yes ☐ No If yes, has the homeowner's association approved the proposed alterations?

If you answered yes to any of the above, please attach a copy of the letter approving the project.

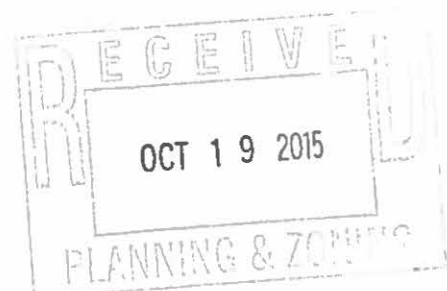

NATURE OF PROPOSED WORK: *Please check all that apply*

- ☐ NEW CONSTRUCTION
☒ EXTERIOR ALTERATION: *Please check all that apply.*
- | | | | |
|-------------------------------------------|----------------------------------------------------------------|-----------------------------------------------------|-----------------------------------|
| <input type="checkbox"/> awning | <input checked="" type="checkbox"/> fence, gate or garden wall | <input type="checkbox"/> HVAC equipment | <input type="checkbox"/> shutters |
| <input checked="" type="checkbox"/> doors | <input checked="" type="checkbox"/> windows | <input type="checkbox"/> siding | <input type="checkbox"/> shed |
| <input type="checkbox"/> lighting | <input type="checkbox"/> pergola/trellis | <input type="checkbox"/> painting unpainted masonry | |
| <input type="checkbox"/> other _____ | | | |
- ☐ ADDITION
☒ DEMOLITION/ENCAPSULATION
☐ SIGNAGE

DESCRIPTION OF PROPOSED WORK: *Please describe the proposed work in detail (Additional pages may be attached).*

NEW OPENINGS & DOORS / WINDOWS AT EXIST
 CARRIAGE HOUSE @ REAR OF PROPERTY.
 NEW GATE @ ALLEY WITH REPAIR TO BRICK WALL

SUBMITTAL REQUIREMENTS:

Items listed below comprise the **minimum supporting materials** for BAR applications. Staff may request additional information during application review. Please refer to the relevant section of the *Design Guidelines* for further information on appropriate treatments.

Applicants must use the checklist below to ensure the application is complete. Include all information and material that are necessary to thoroughly describe the project. Incomplete applications will delay the docketing of the application for review. Pre-application meetings are required for all proposed additions. All applicants are encouraged to meet with staff prior to submission of a completed application.

Electronic copies of submission materials should be submitted whenever possible.

Demolition/Encapsulation : *All applicants requesting 25 square feet or more of demolition/encapsulation must complete this section. Check N/A if an item in this section does not apply to your project.*

- N/A
- | | |
|--------------------------|---|
| <input type="checkbox"/> | <input type="checkbox"/> Survey plat showing the extent of the proposed demolition/encapsulation. |
| <input type="checkbox"/> | <input type="checkbox"/> Existing elevation drawings clearly showing all elements proposed for demolition/encapsulation. |
| <input type="checkbox"/> | <input type="checkbox"/> Clear and labeled photographs of all elevations of the building if the entire structure is proposed to be demolished. |
| <input type="checkbox"/> | <input type="checkbox"/> Description of the reason for demolition/encapsulation. |
| <input type="checkbox"/> | <input type="checkbox"/> Description of the alternatives to demolition/encapsulation and why such alternatives are not considered feasible. |

Additions & New Construction: Drawings must be to scale and should not exceed 11" x 17" unless approved by staff. All plans must be folded and collated into 3 complete 8 1/2" x 11" sets. Additional copies may be requested by staff for large-scale development projects or projects fronting Washington Street. Check N/A if an item in this section does not apply to your project.

- ☐ ☐ N/A
- ☐ ☐ Scaled survey plat showing dimensions of lot and location of existing building and other structures on the lot, location of proposed structure or addition, dimensions of existing structure(s), proposed addition or new construction, and all exterior, ground and roof mounted equipment.
 - ☐ ☐ FAR & Open Space calculation form.
 - ☐ ☐ Clear and labeled photographs of the site, surrounding properties and existing structures, if applicable.
 - ☐ ☐ Existing elevations must be scaled and include dimensions.
 - ☐ ☐ Proposed elevations must be scaled and include dimensions. Include the relationship to adjacent structures in plan and elevations.
 - ☐ ☐ Materials and colors to be used must be specified and delineated on the drawings. Actual samples may be provided or required.
 - ☐ ☐ Manufacturer's specifications for materials to include, but not limited to: roofing, siding, windows, doors, lighting, fencing, HVAC equipment and walls.
 - ☐ ☐ For development site plan projects, a model showing mass relationships to adjacent properties and structures.

Signs & Awnings: One sign per building under one square foot does not require BAR approval unless illuminated. All other signs including window signs require BAR approval. Check N/A if an item in this section does not apply to your project.

- ☐ ☐ N/A
- ☐ ☐ Linear feet of building: Front: _____ Secondary front (if corner lot): _____.
 - ☐ ☐ Square feet of existing signs to remain: _____.
 - ☐ ☐ Photograph of building showing existing conditions.
 - ☐ ☐ Dimensioned drawings of proposed sign identifying materials, color, lettering style and text.
 - ☐ ☐ Location of sign (show exact location on building including the height above sidewalk).
 - ☐ ☐ Means of attachment (drawing or manufacturer's cut sheet of bracket if applicable).
 - ☐ ☐ Description of lighting (if applicable). Include manufacturer's cut sheet for any new lighting fixtures and information detailing how it will be attached to the building's facade.

Alterations: Check N/A if an item in this section does not apply to your project.

- ☐ ☐ N/A
- ☐ ☐ Clear and labeled photographs of the site, especially the area being impacted by the alterations, all sides of the building and any pertinent details.
 - ☐ ☐ Manufacturer's specifications for materials to include, but not limited to: roofing, siding, windows, doors, lighting, fencing, HVAC equipment and walls.
 - ☐ ☐ Drawings accurately representing the changes to the proposed structure, including materials and overall dimensions. Drawings must be to scale.
 - ☐ ☐ An official survey plat showing the proposed locations of HVAC units, fences, and sheds.
 - ☐ ☐ Historic elevations or photographs should accompany any request to return a structure to an earlier appearance.

ALL APPLICATIONS: *Please read and check that you have read and understand the following items:*

- ☒ I have submitted a filing fee with this application. (Checks should be made payable to the City of Alexandria. Please contact staff for assistance in determining the appropriate fee.)
- ☒ I understand the notice requirements and will return a copy of the three respective notice forms to BAR staff at least five days prior to the hearing. If I am unsure to whom I should send notice I will contact Planning and Zoning staff for assistance in identifying adjacent parcels.
- ☒ I, the applicant, or an authorized representative will be present at the public hearing.
- ☒ I understand that any revisions to this initial application submission (including applications deferred for restudy) must be accompanied by the BAR Supplemental form and 3 sets of revised materials.

The undersigned hereby attests that all of the information herein provided including the site plan, building elevations, prospective drawings of the project, and written descriptive information are true, correct and accurate. The undersigned further understands that, should such information be found incorrect, any action taken by the Board based on such information may be invalidated. The undersigned also hereby grants the City of Alexandria permission to post placard notice as required by Article XI, Division A, Section 11-301(B) of the 1992 Alexandria City Zoning Ordinance, on the property which is the subject of this application. The undersigned also hereby authorizes the City staff and members of the BAR to inspect this site as necessary in the course of research and evaluating the application. The applicant, if other than the property owner, also attests that he/she has obtained permission from the property owner to make this application.


APPLICANT OR AUTHORIZED AGENT:

Signature: _____

Printed Name: _____

Date: _____

PATRICK CAMUS19 OCT 15

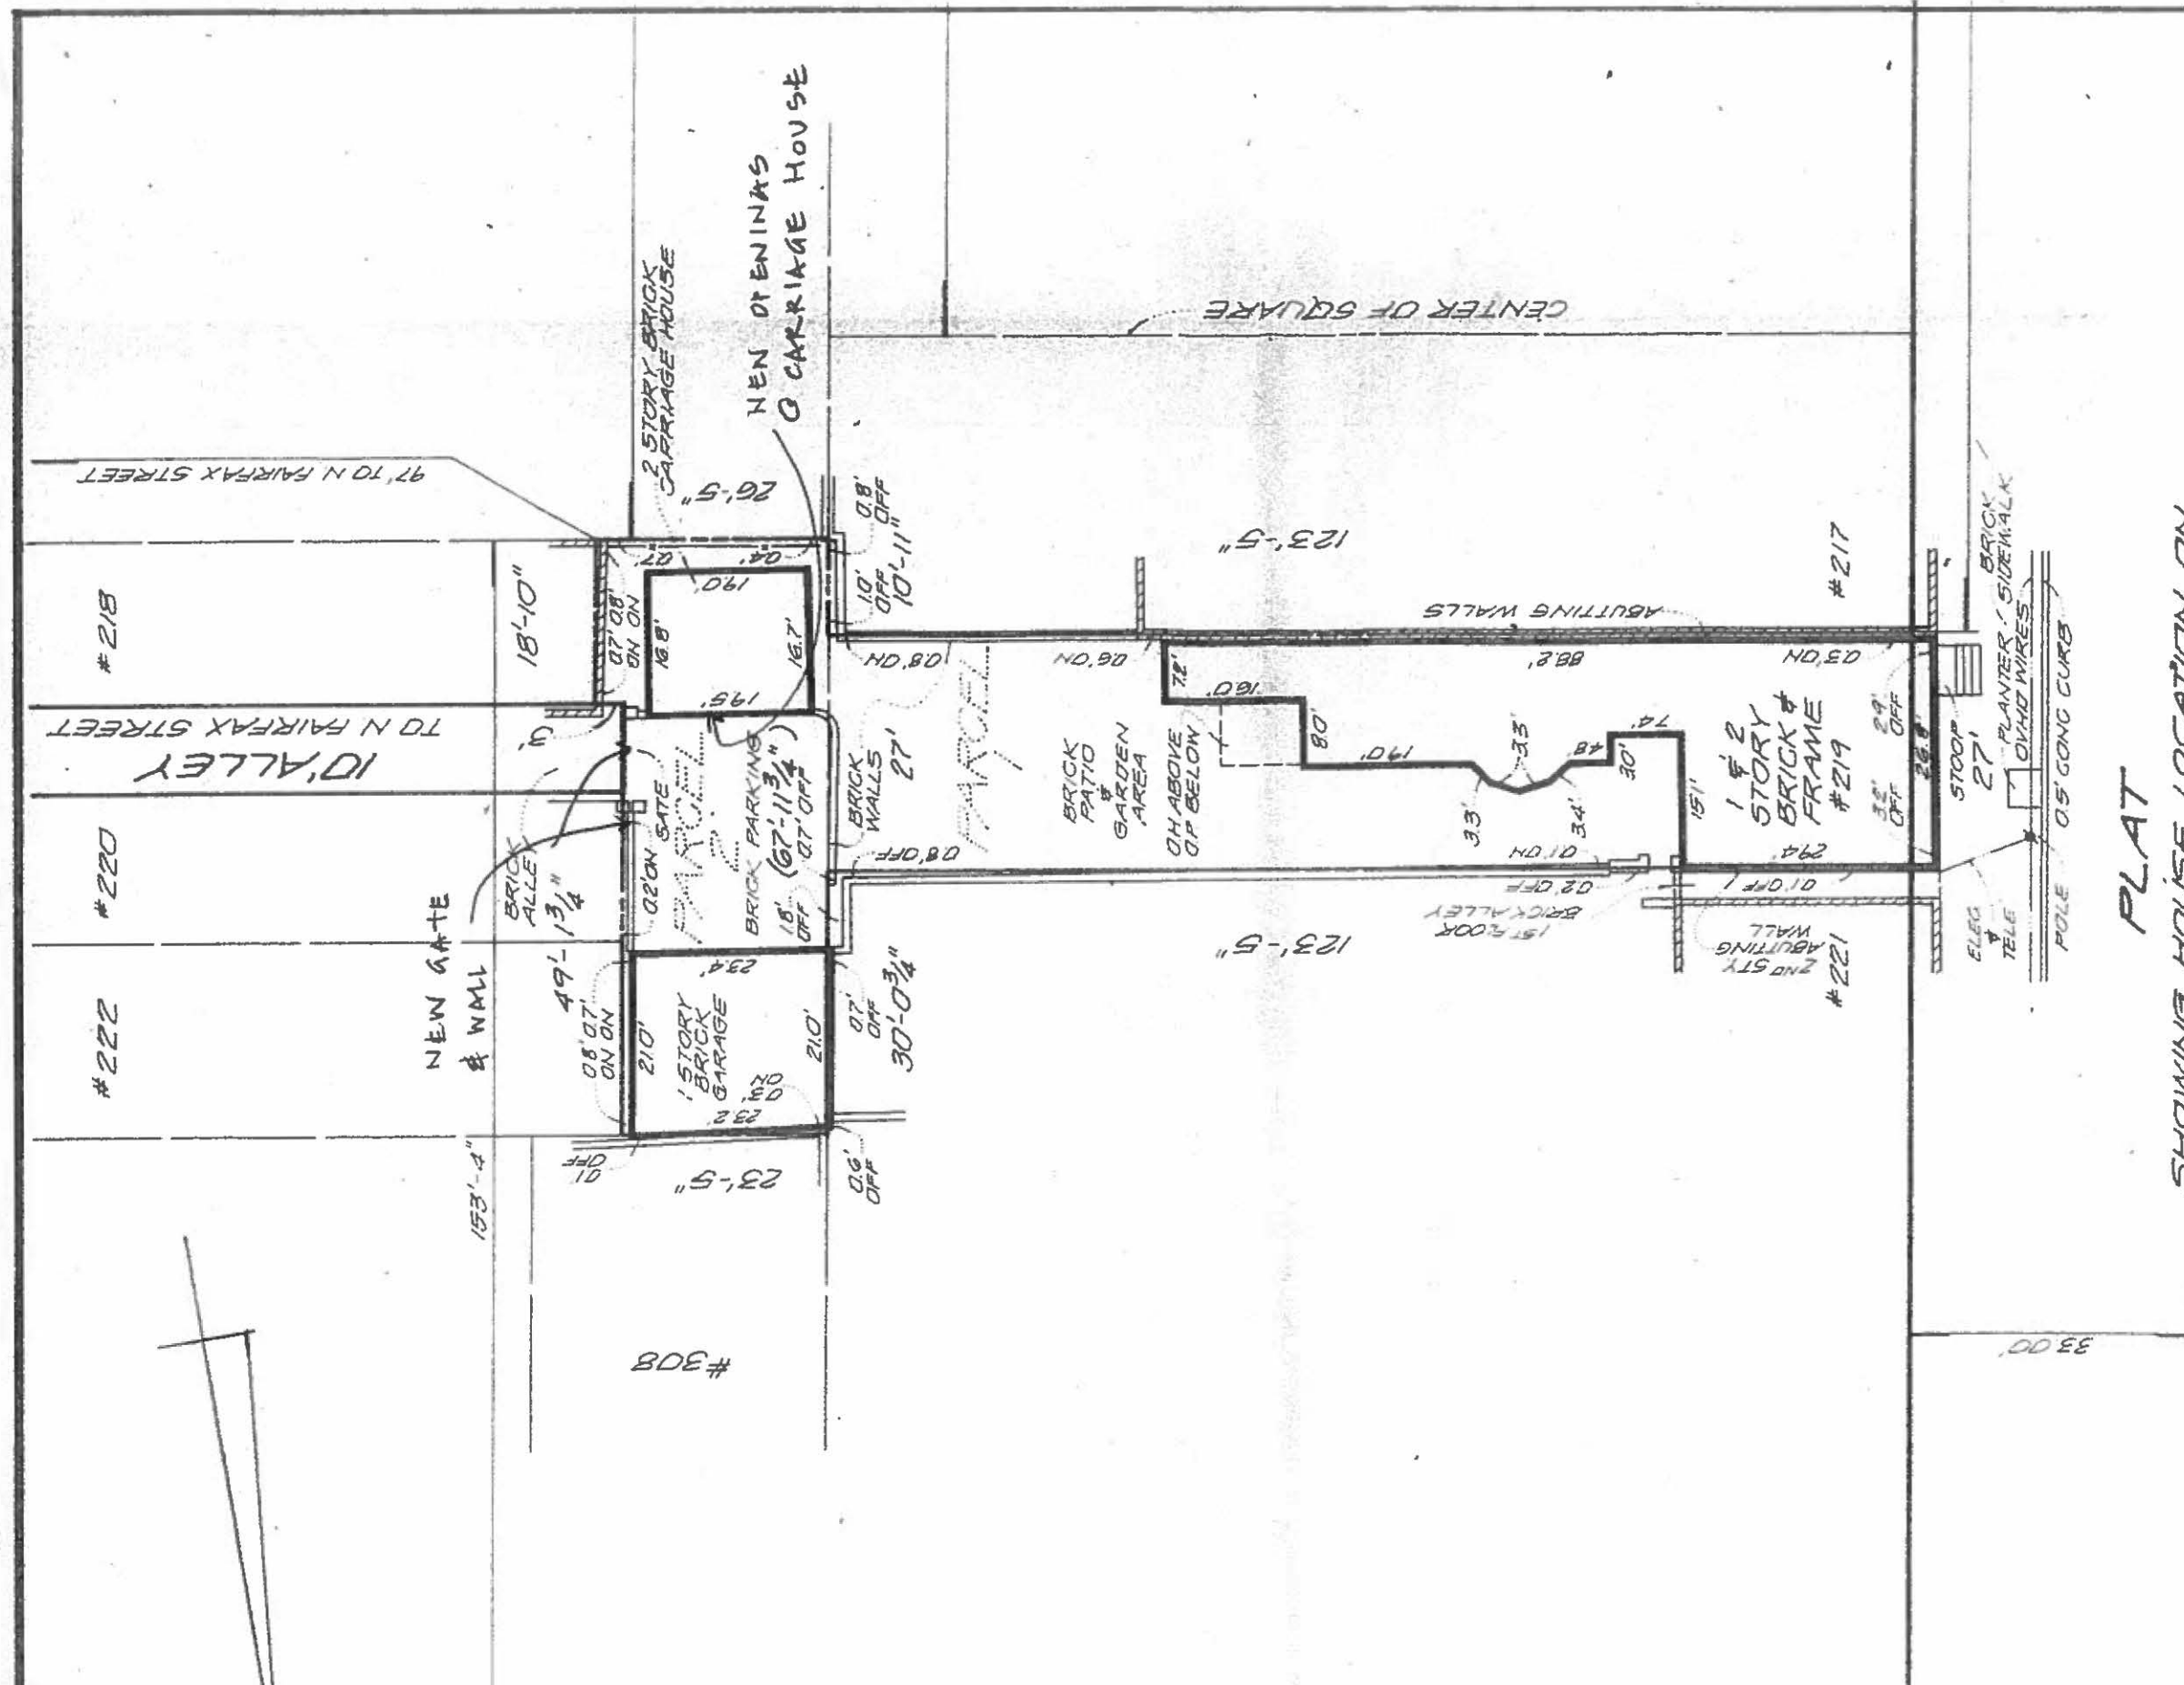

PLAT
 SHOWING HOUSE LOCATED ON
 THE PROPERTY LOCATED AT

219 NORTH ROYAL STREET CITY OF ALEXANDRIA, VIRGINIA

SCALE: 1"=20' APRIL 19, 1990

THIS PROPERTY IS NOT LOCATED IN A
 H.U.D. DESIGNATED FLOOD HAZARD
 ZONE.
 PLAT SUBJECT TO RESTRICTIONS OF
 RECORD.
 TITLE REPORT NOT FURNISHED.

I HEREBY CERTIFY THAT THE POSITIONS OF
 ALL THE EXISTING IMPROVEMENTS HAVE BEEN
 CAREFULLY ESTABLISHED BY A TRANSIT TAPE
 SURVEY AND UNLESS OTHERWISE SHOWN,
 THERE ARE NO VISIBLE ENCROACHMENTS.

Kenneth W. White





CASE NAME:
DAMERON - CANFIELD
MAYS & VALENTINE

ALEXANDRIA SURVEYS, INC.
 6343 SOUTH KINGS HIGHWAY
 ALEXANDRIA, VIRGINIA 22306
 703-680-8515
 FAX 703-768-7764

APPLICATION MATERIAL
 BAR2015-00348
 219 N Royal St
 10/19/2015

| | | | | |
|--------------------------|---|---|-----------|-------|
| <div>C²</div> | <div>STUDIO CAMUS LLC</div> <div>225 North Pitt Street Alexandria Virginia 22314.</div> <div>studiocamus@comcast.net</div> <div>Lynnette 703 989 3777 Patrick 703 626 1984</div> | <div>Proposed Modifications to the</div> <div>CANFIELD RESIDENCE</div> <div>219 North Royal Street Alexandria Virginia</div> | DATE | SHEET |
| | | | SCALE | |
| | | | 19 OCT 15 | C.S |
| | | | AS NOTED | |

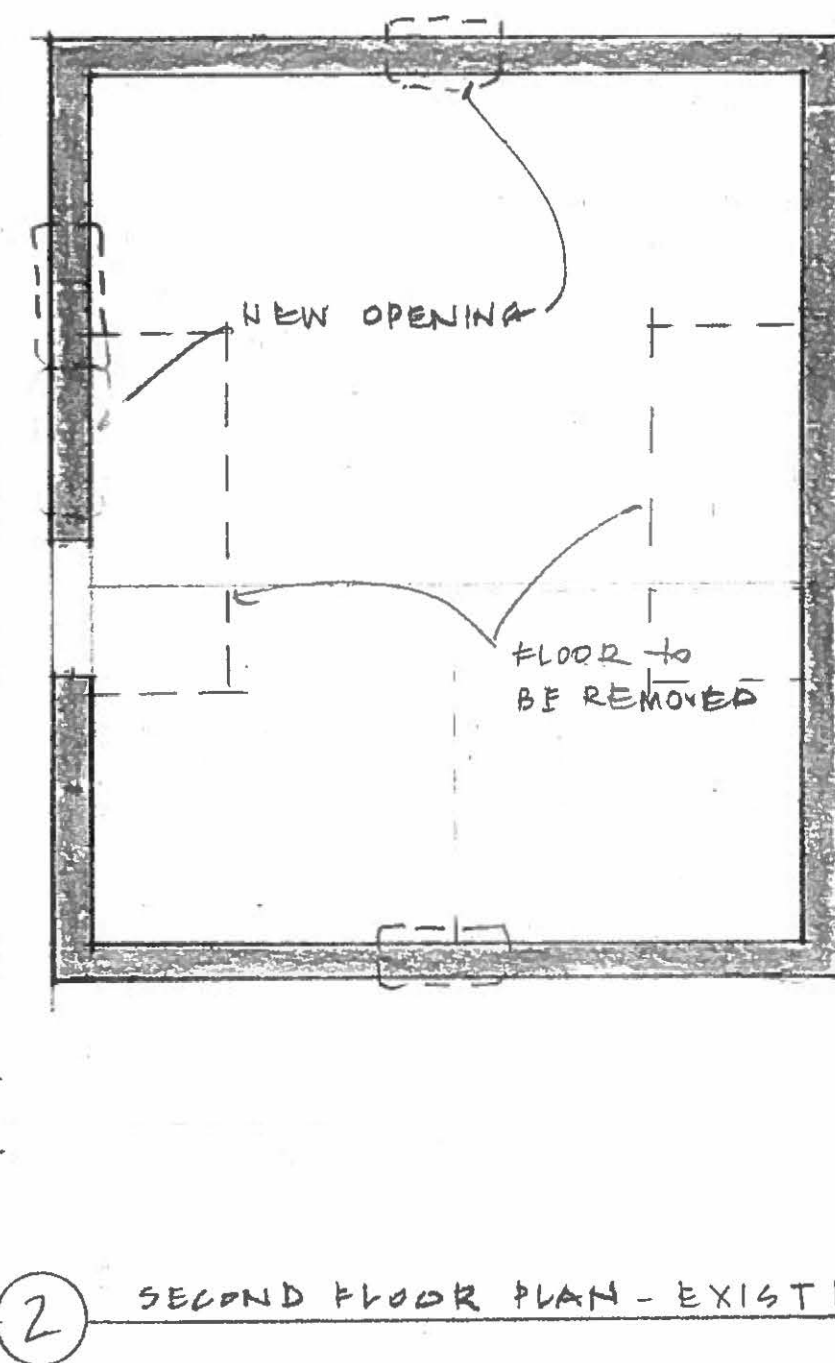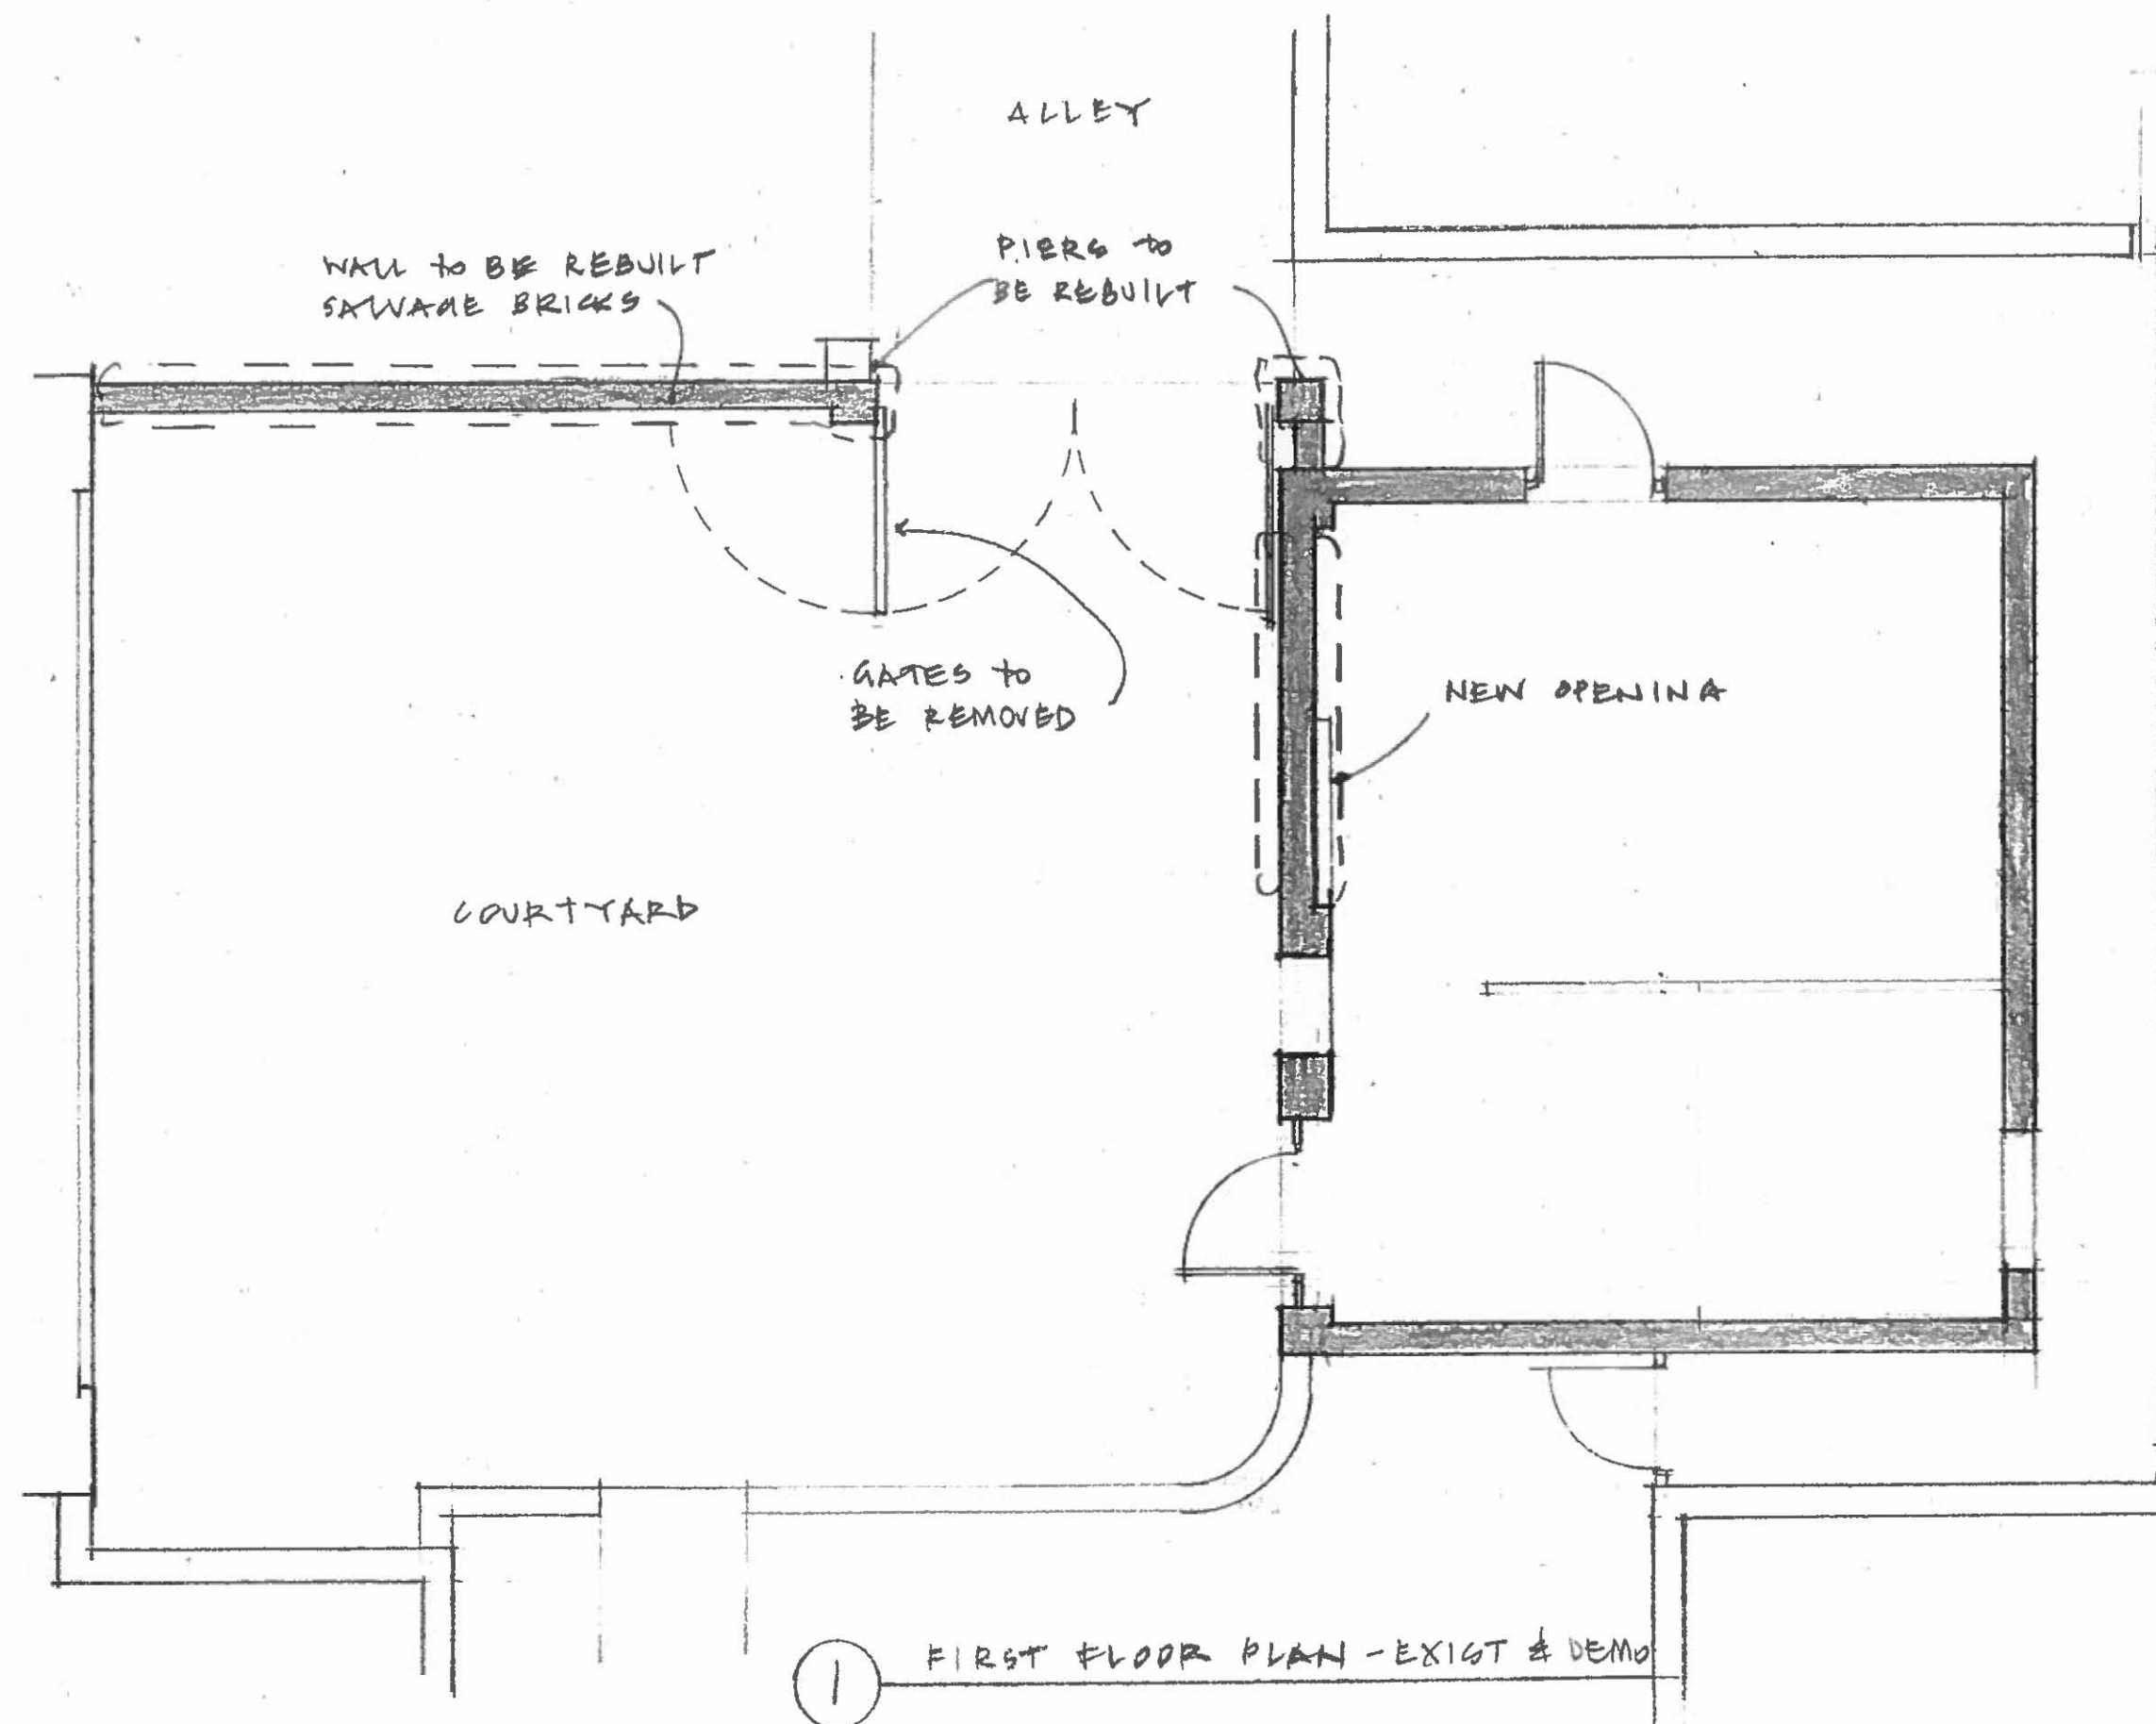

APPLICATION MATERIALS
 BAR2015-00348
 219 N Royal St
 10/19/2015

GARAGE

BRICK WALL & PIERS TO
 BE REBUILT

EXIST BRICK

3 WALL ELEVATION (COURTYARD)

ROOF TO BE
 REMOVED

NEW
 OPENINGS

NEW OPENING

EXIST BRICK

1 NORTH ELEVATION - EXIST & DEMOLITION

2 WEST ELEVATION - EXIST & DEMO

C²

STUDIO CAMUS LLC

225 North Pitt Street Alexandria Virginia 22314

luc@camusarchitects.net

Lynnette 703 989 3777

Patrick 703 626 1984

Proposed Modifications to the
 CANFIELD RESIDENCE

219 North Royal Street Alexandria Virginia

DATE


10/01/15

SCALE


1/4" = 1'-0"

SHEET

A2

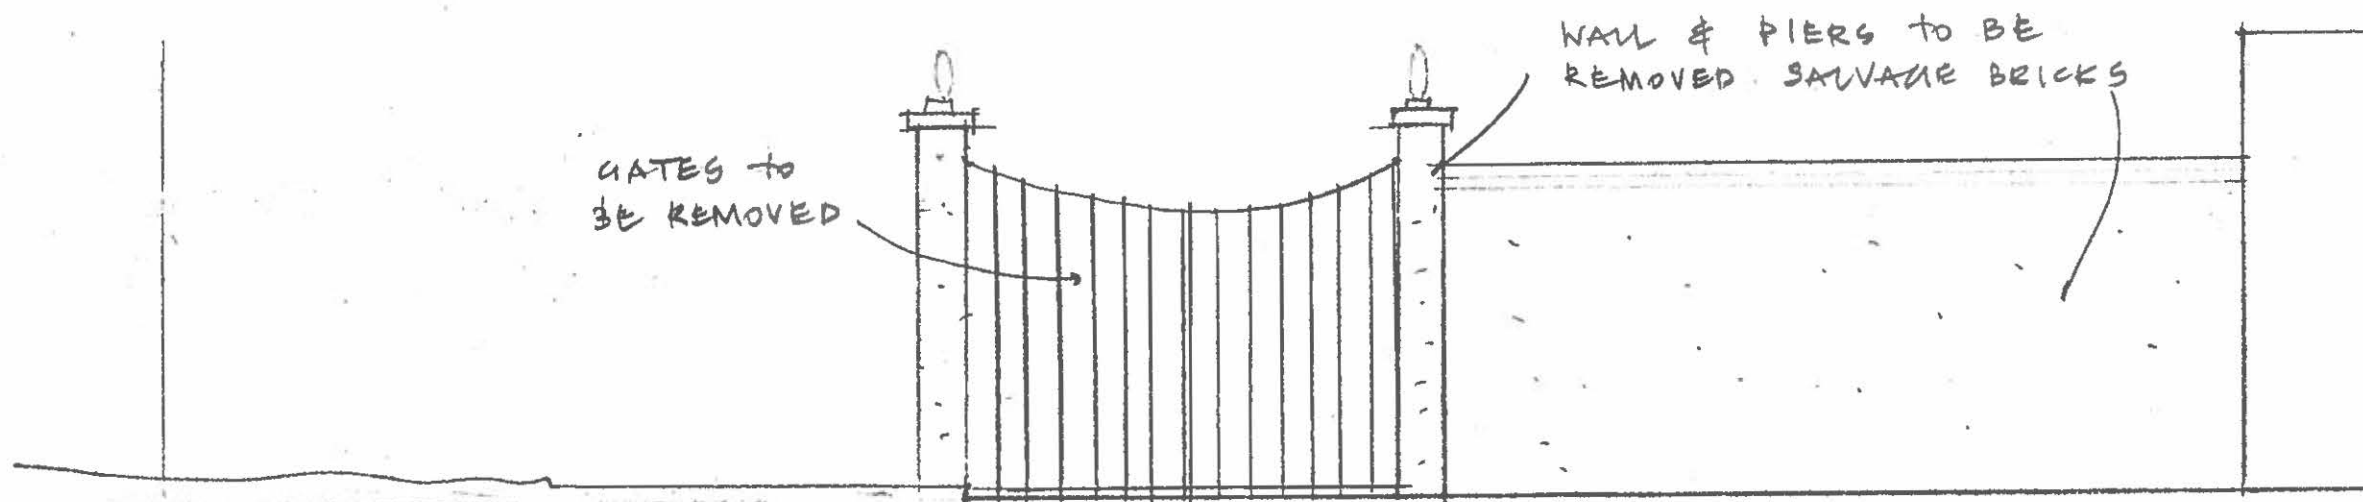



3 ALLEY ELEVATION

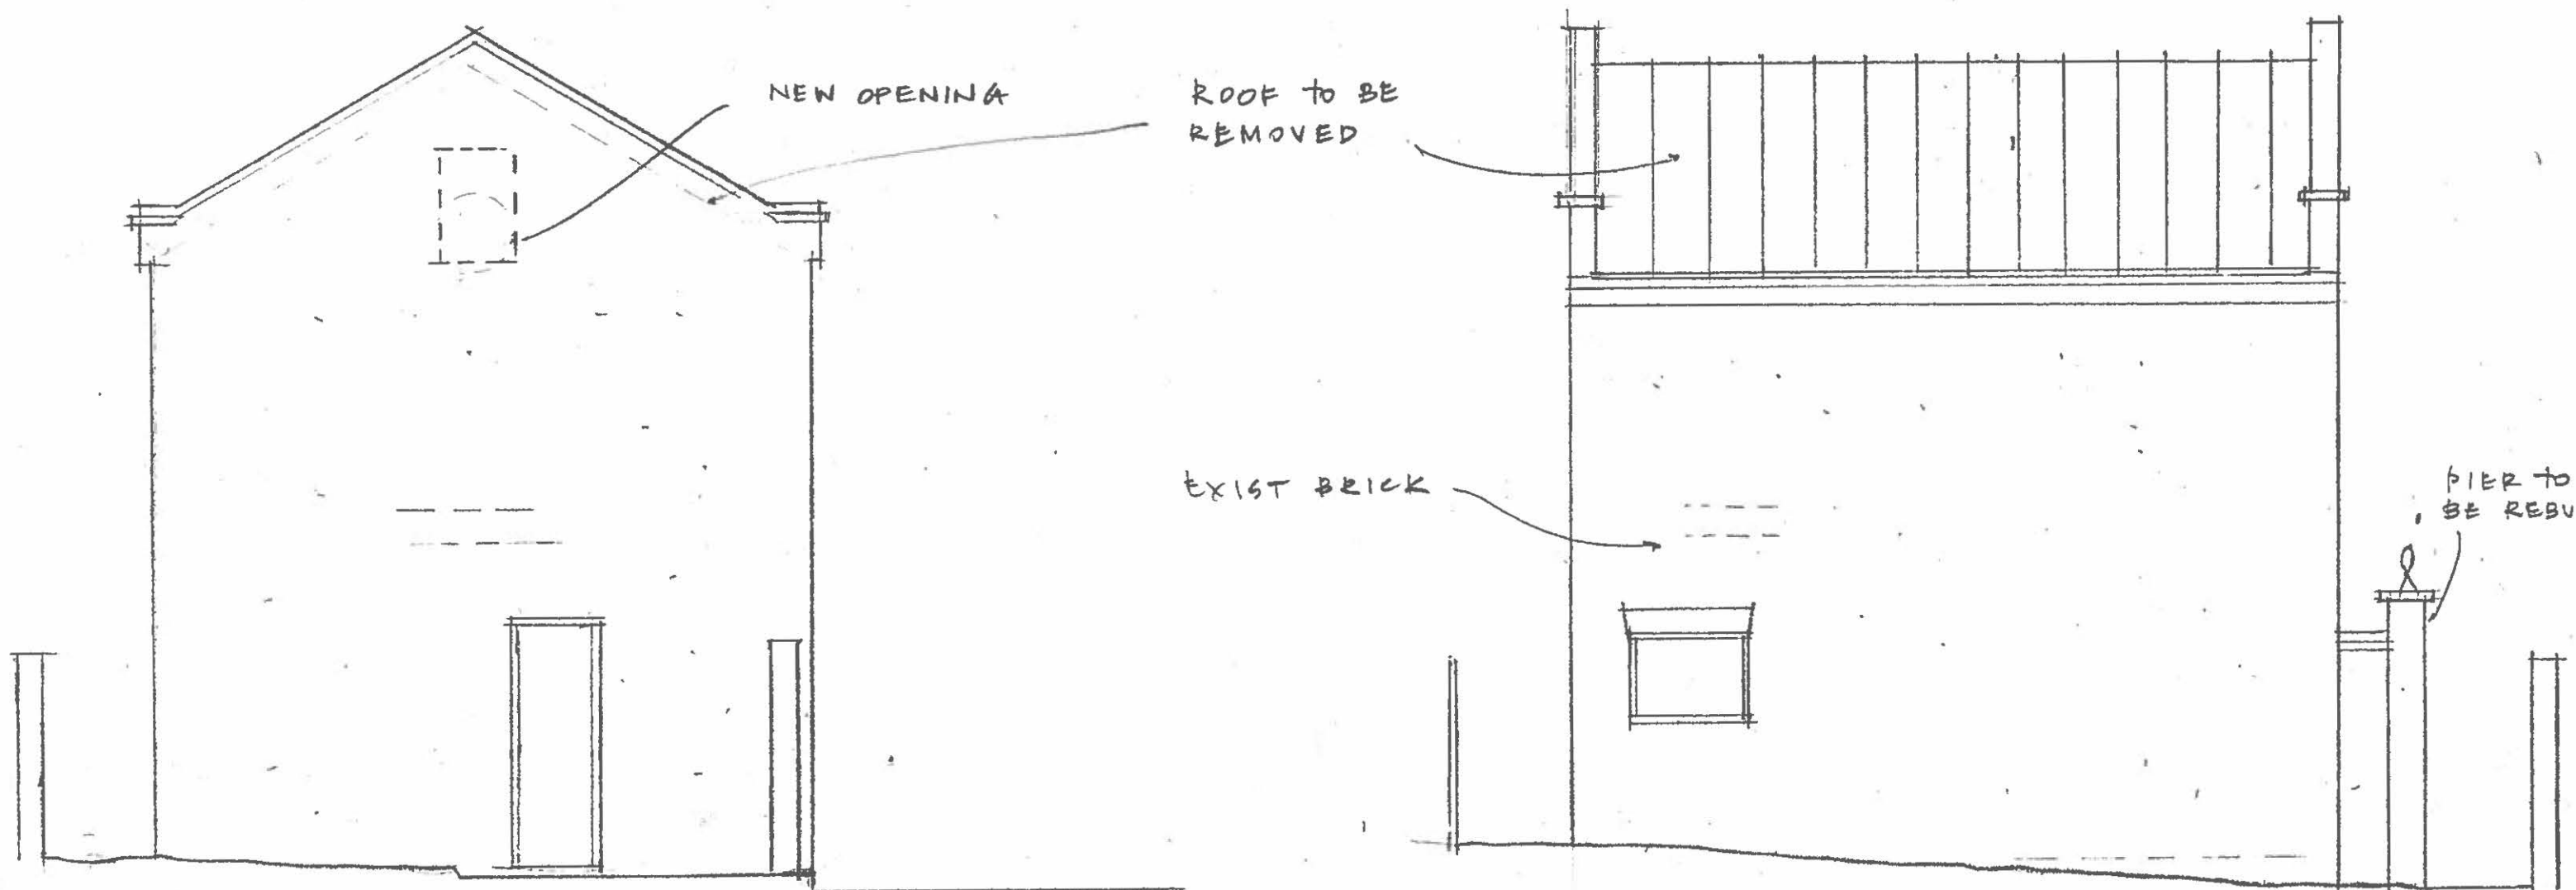

1 EAST ELEVATION EXIST & DEMOLITION

2 SOUTH ELEVATION EXIST & DEMOLITION

| | | |
|---|---|-------------------------------------------------------------------------------|
| <p>C² STUDIO CAMUS LLC 225 North Pitt Street Alexandria Virginia 22314 Lynnette 703 989 3777 Patrick 703 626 1984</p> | <p>Proposed Modifications to the CANFIELD RESIDENCE 219 North Royal Street Alexandria Virginia</p> | <p>DATE 19 OCT 15 SCALE 1/4"=1'-0"</p> <p>SHEET A3</p> |
|---|---|-------------------------------------------------------------------------------|

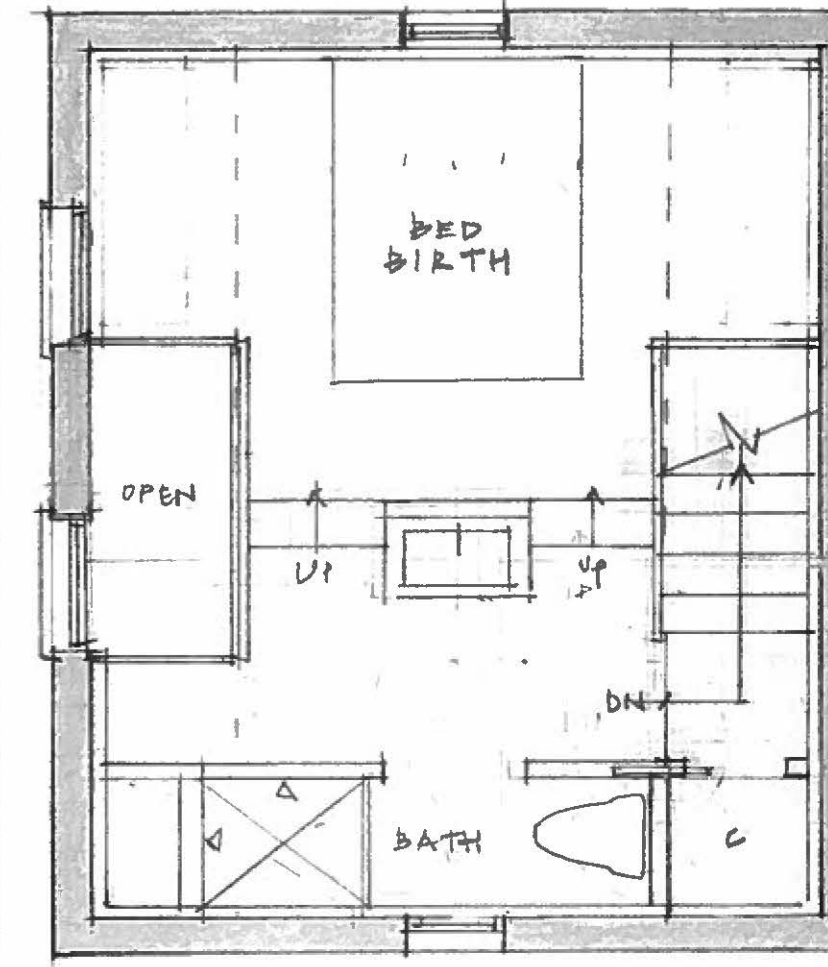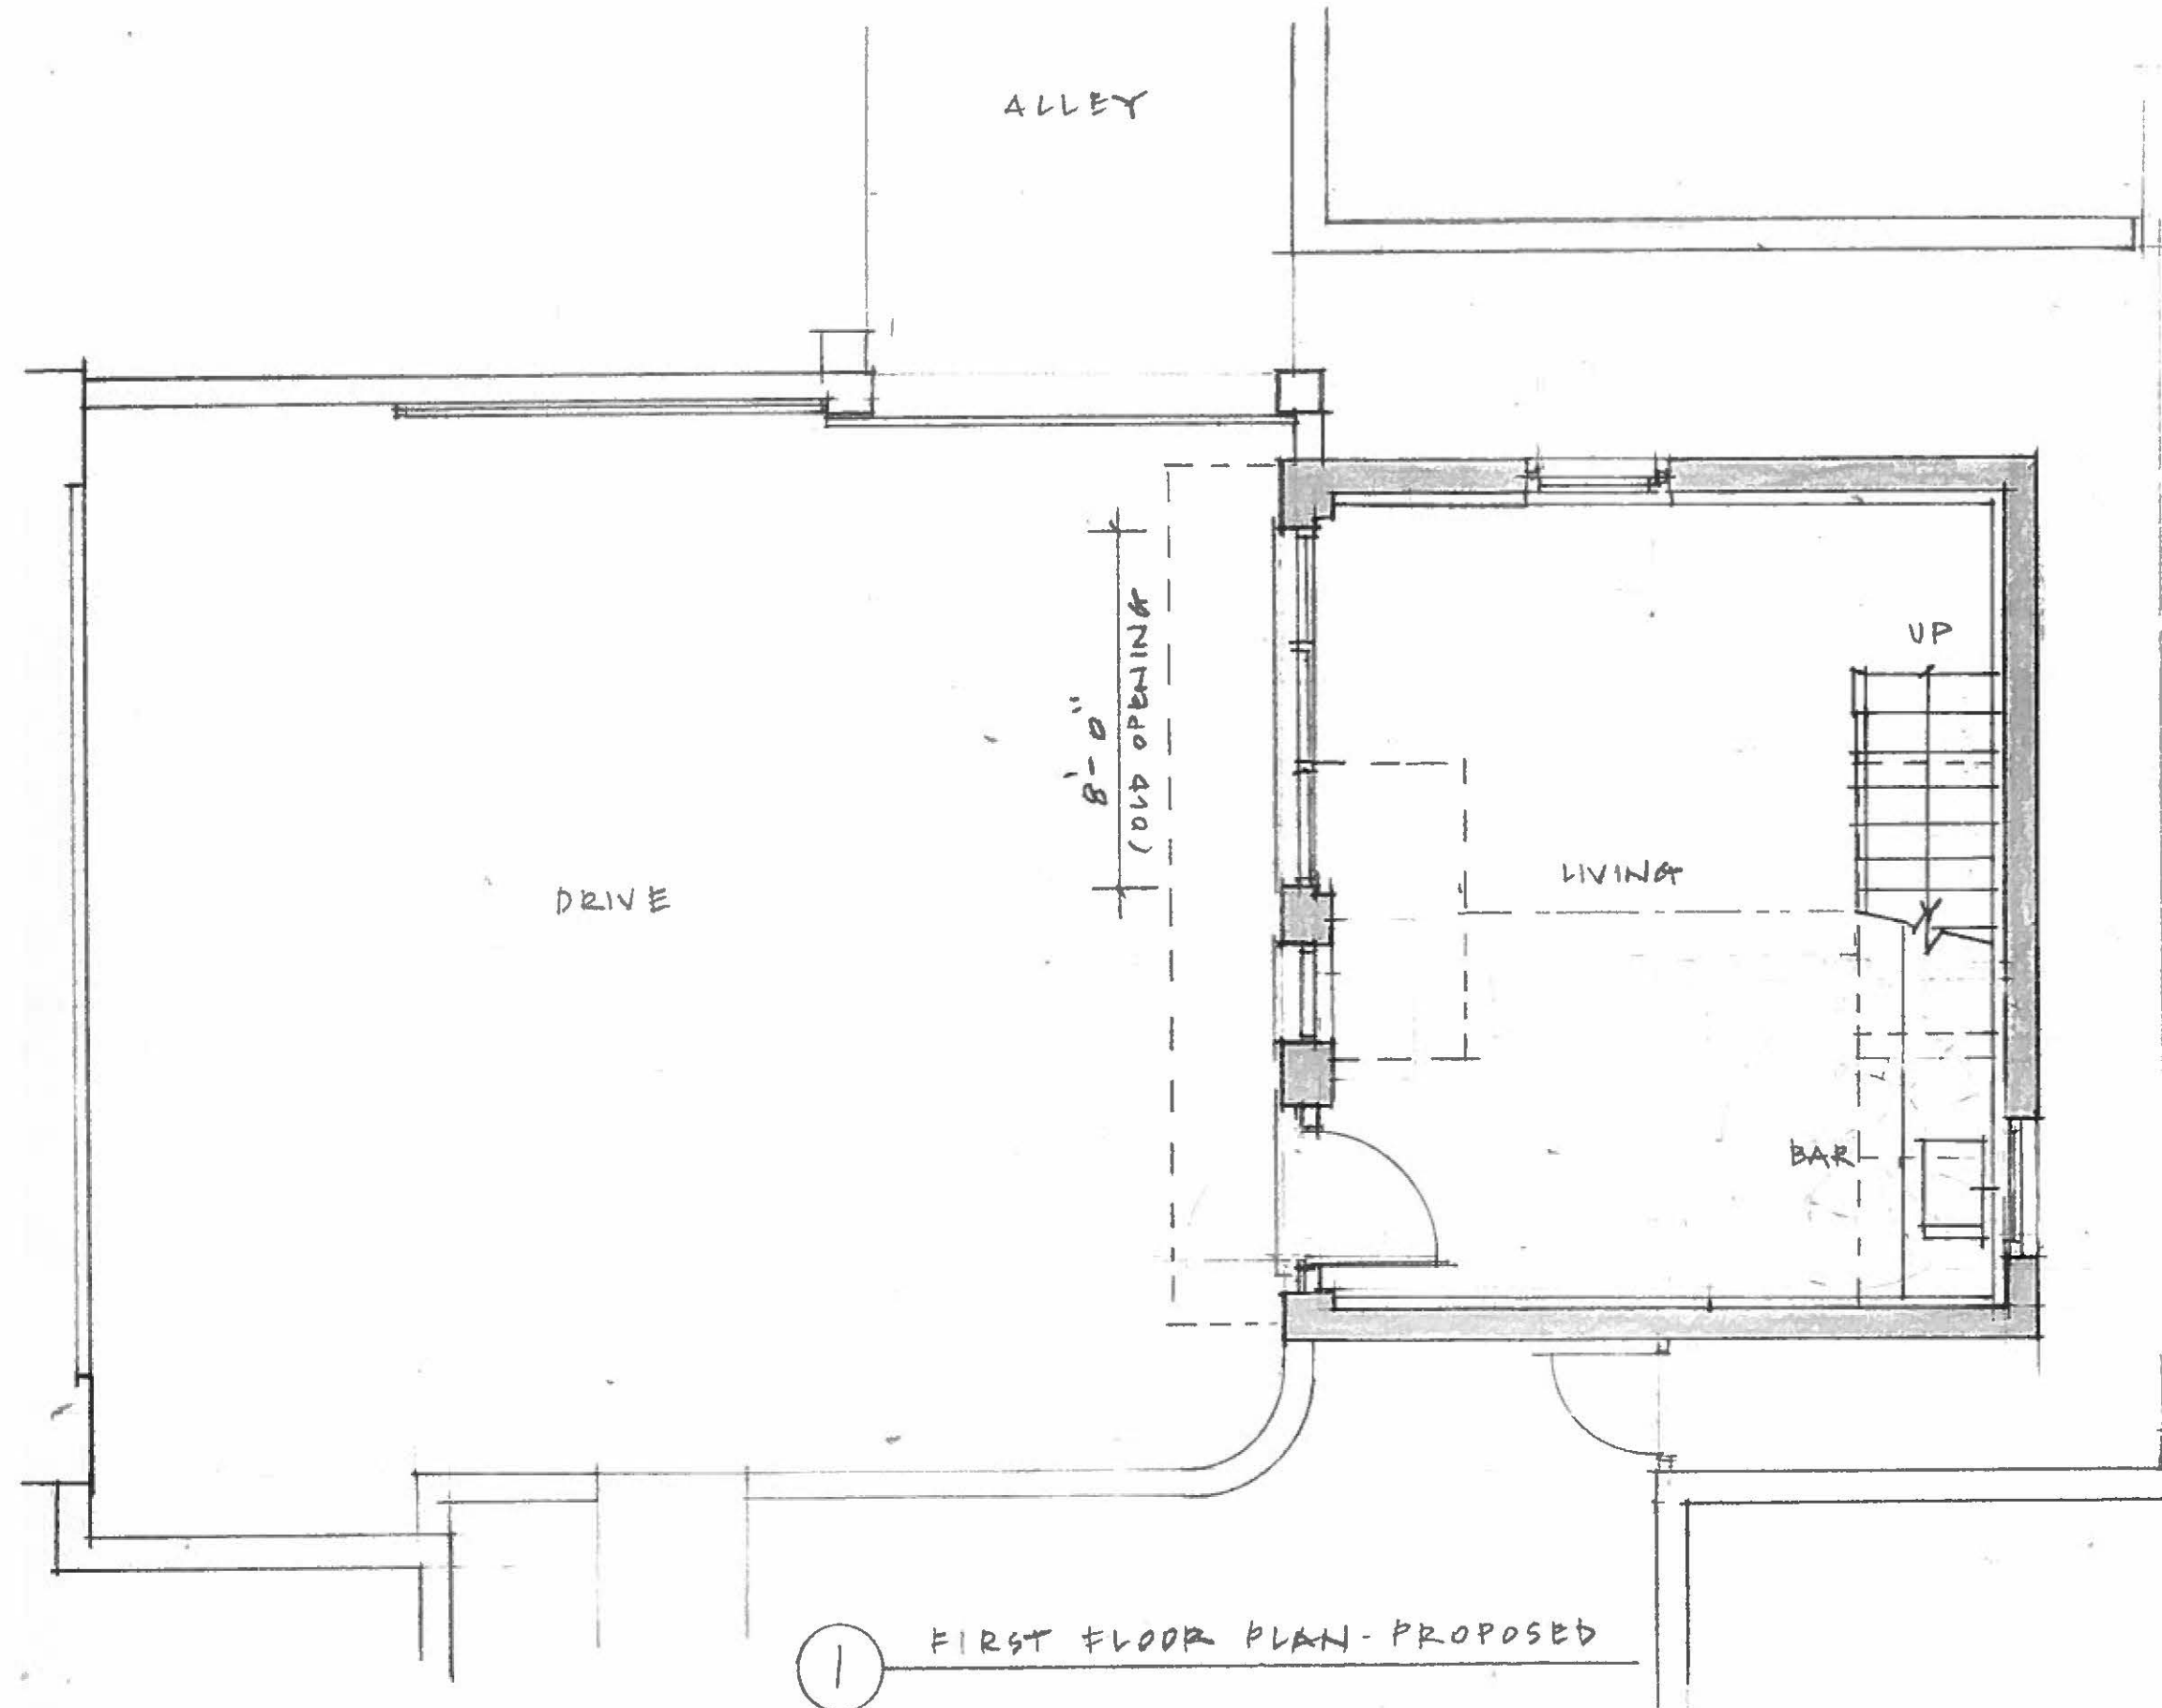

1 FIRST FLOOR PLAN - PROPOSED

2 SECOND FLOOR PLAN PROPOSED

APPLICATION MATERIALS
 BAR2015-00348
 219 N Royal St
 10/19/2015


GARAGE

REBUILT BRICK WALL
 IN KIND


NEW WOOD
 GATE, SLIDING

REBUILT PIER - IN KIND
 EXIST WALL

3 WALL ELEVATION (COURTYARD)

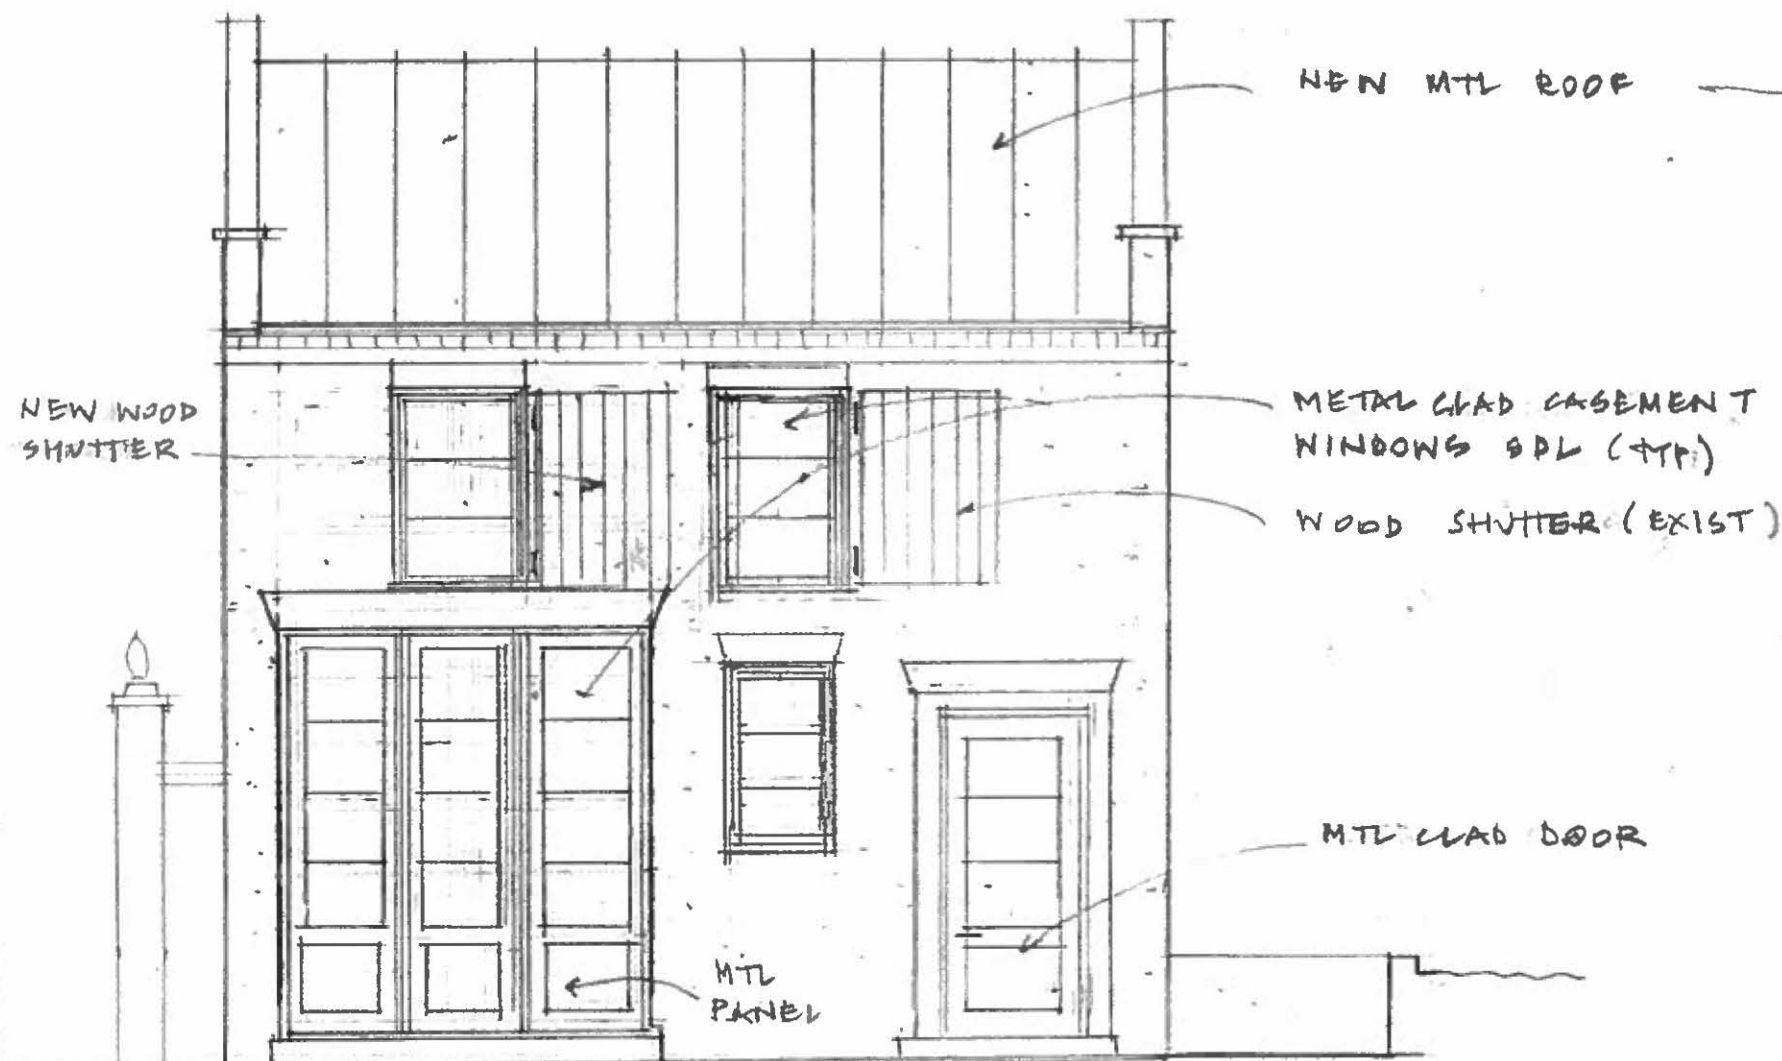

1 NORTH ELEVATION - PROPOSED

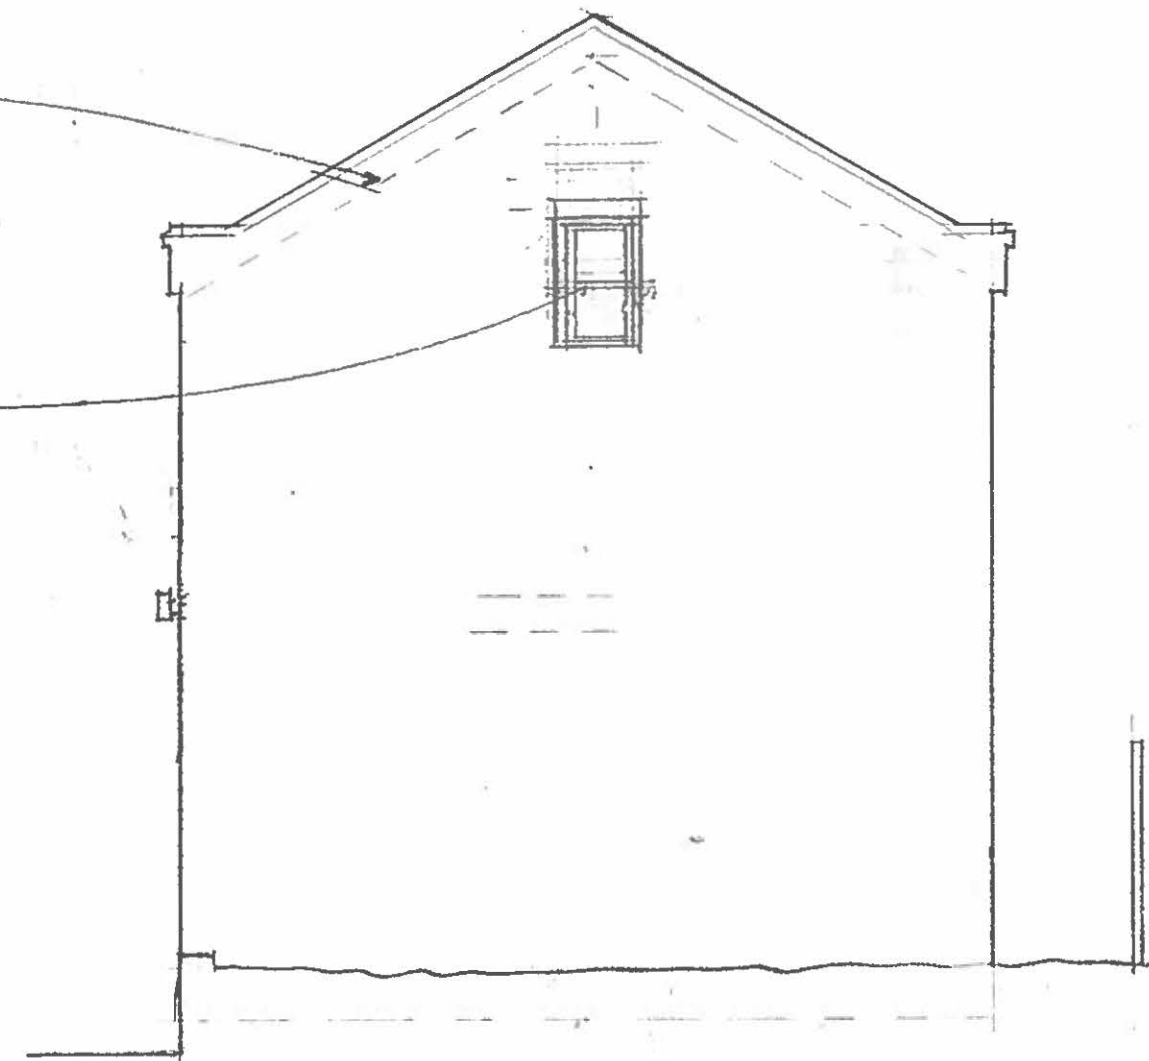

2 WEST ELEVATION - PROPOSED

C²

STUDIO CAMUS LLC
 225 North Pitt Street Alexandria Virginia 22314
 Lynnelle 703 989 3777 Patrick 703 626 1984

Proposed Modifications to the
 CANFIELD RESIDENCE
 219 North Royal Street Alexandria Virginia

DATE
 10 OCT 15
 SCALE
 1/4" = 1'-0"

SHEET
 A5


APPLICATION MATERIALS
BAR2015-00348
219 N Royal St
10/19/2015

NEW PAINTED WOOD GATE
(SLIDING)


REBUILT WALL
& PIERS

EXIST GARAGE

3 ALLEY ELEVATION

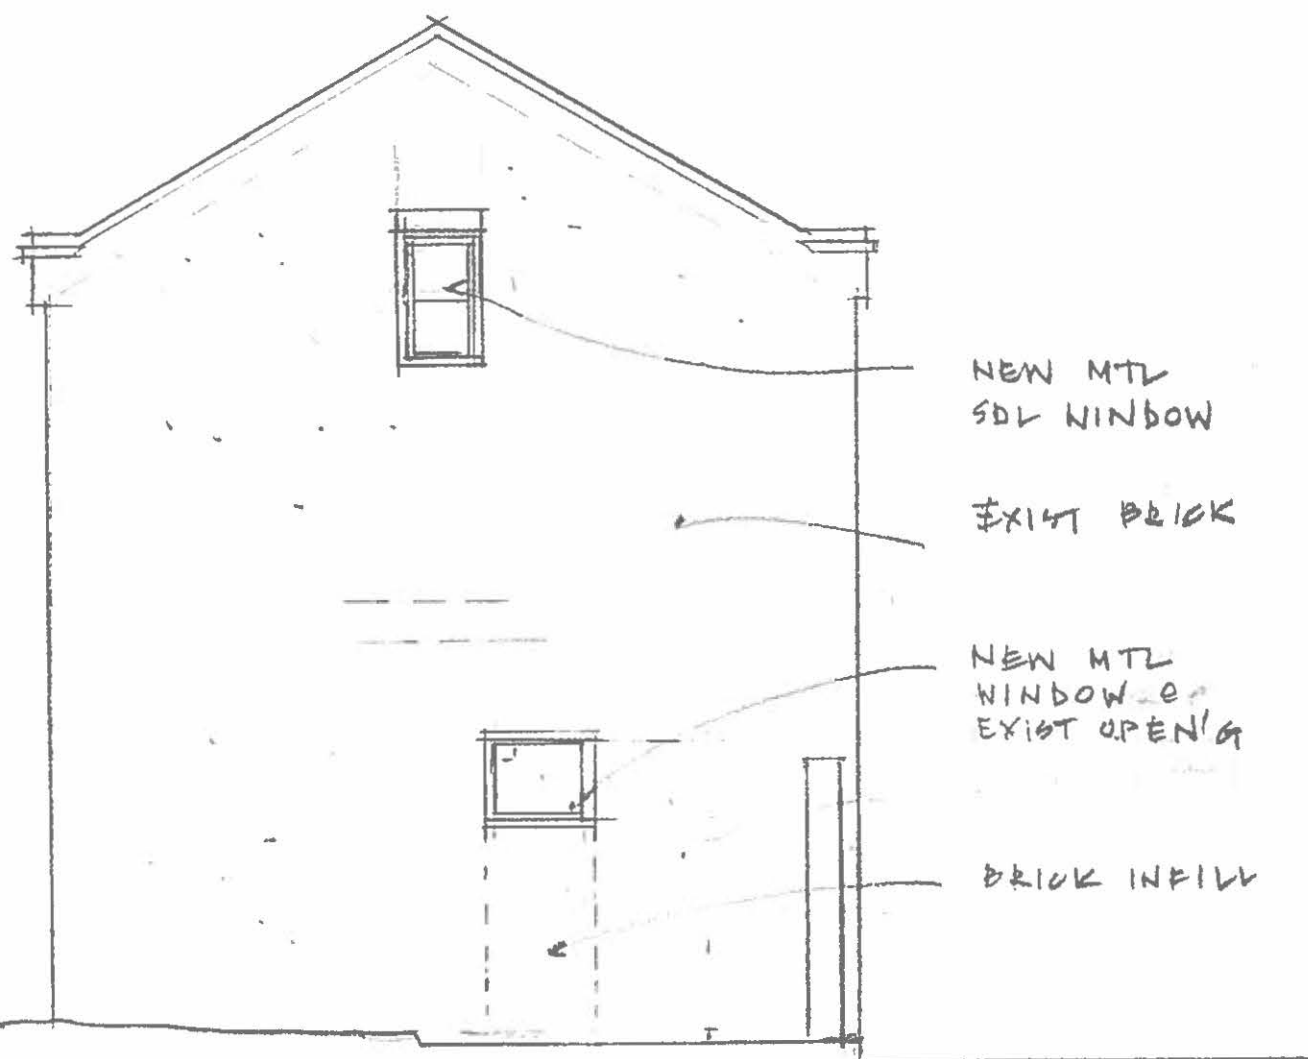

1 EAST ELEVATION - PROPOSED

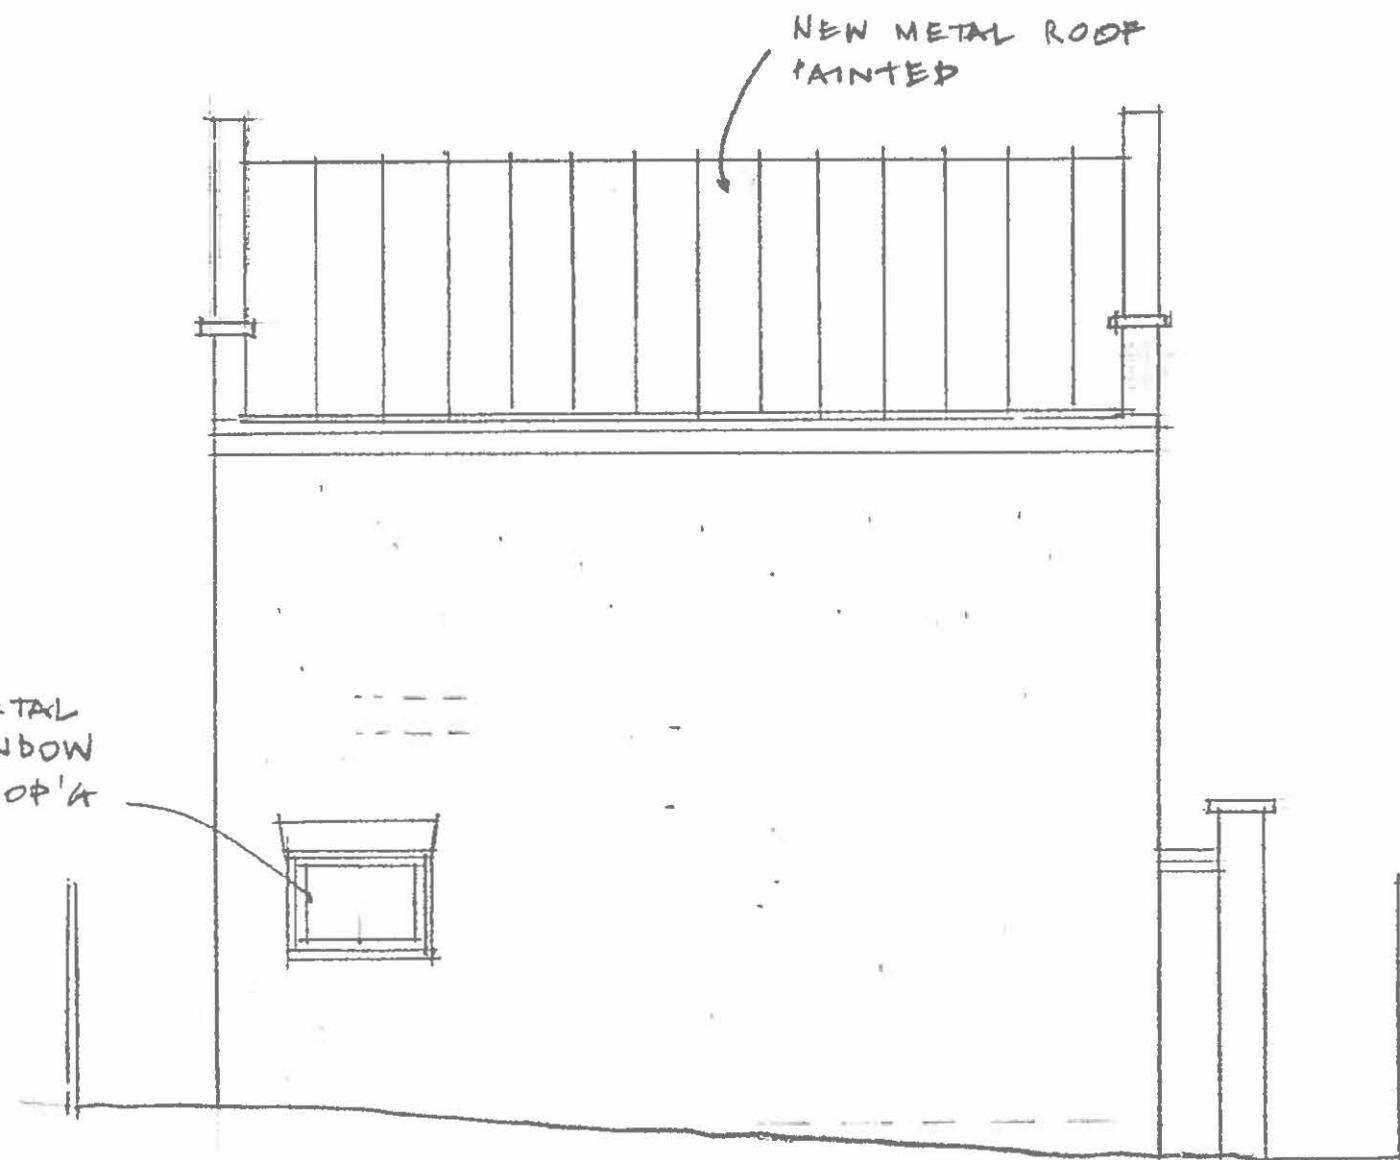

2 SOUTH ELEVATION - PROPOSED

C²

STUDIO CAMUS LLC
225 North Pitt Street Alexandria Virginia 22314
studio.camus@comcast.net
Lynnette 703 989 3777 Patrick 703 626 1984

Proposed Modifications to the
CANFIELD RESIDENCE
219 North Royal Street Alexandria Virginia

DATE
19 OCT 15
SCALE
1/4" = 1'-0"

SHEET
A6



ALLEY
(FROM FAIRFAX)



COURTYARD



C²

STUDIO CAMUS LLC
225 North Pitt Street Alexandria Virginia 22314
studiocamus@comcast.net
Lynnette 703 989 3777 Patrick 703 626 1984

APPLICATION MATERIALS
BAR2015-00348
219 N Royal St
10/19/2015

Proposed Modifications to the
CANFIELD RESIDENCE
219 North Royal Street Alexandria Virginia

DATE
19 OCT 15
SCALE
NTS


SHEET
A7



JELD WEN Simulated Divided Lites

(SDL) grilles that are permanently attached to both the interior and exterior glass (aluminum for clad exteriors, wood for wood exteriors), metal bars placed between the panes of insulating glass to provide design detail.

Grilles 7/8" width in putty profile: These grilles are available in wood for wood exteriors or the color that matches the exterior clad color of the window you choose or a custom color.

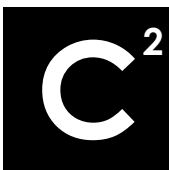

STUDIO CAMUS LLC
225 North Pitt Street Alexandria Virginia 22314
studiocamus@comcast.net
Lynnette 703 989 3777 Patrick 703 626 1984

219 North Royal Street
Metal clad window specs